





Work Order ID 54369 -1



December 8, 2009 11:24:49 AM

Split




Page 1

Item ID: D3303-041 Accept  Setup Start 
 Revision ID:
 Item Name: Head Rest Stop 
 Start Date: 08/12/2009 Start Qty: ~~40.00~~ ²⁰  Cust Item ID:
 Required Date: 16/12/2009 Req'd Qty: 40.00  Customer:
 Reference:
 Approvals: Process Plan: *RP* Date: *04-0-5* Tooling: _____ Date: _____
 QC: _____ Date: _____ SPC (Y/N): _____ Date: _____


Run Start 
 Stop 

Sequence ID/ Work Center ID	Operation Description	Set Up/ Run Hours	Draw Number	Draw Rev.	Plan Code	Accept Qty	Reject Qty	Reject Number	Insp. Stamp
--------------------------------	--------------------------	----------------------	----------------	--------------	--------------	---------------	---------------	------------------	----------------

Draw Nbr	Revision Nbr
D3303	Rev B


100		0.00							
	Small Fab								
Small Fab	Memo	0.00							
Small Fab	1- Bond foam to D3303-043 bracket assembly as per Dwg D3303 using 3M 1300/1300L adhesive. Identify as D3303-041 A/R 3M 1300/1300L Adhesive Batch: <i>4/13/74</i> 2- Cover Head Rest with D3306-041 as per Dwg D3303								

CP 10/01/25 (20)

110		0.00							
	QC5- Inspect part completeness to step on W/O								
QC	Memo	0.00							
Quality Control									

=> Solver

counter x20

120		0.00							
	Packaging								
Packaging	Memo	0.00							
Packaging	Identify with P/N and B/N, also identify the back of the headrest with TCCA-PDA # PDA04-11 using a permanent fine point marker as per Dwg D3303, then Stock Location: <i>186</i>								

10-1-25 (20x) SP

W/O:		WORK ORDER CHANGES						
DATE	STEP	PROCEDURE CHANGE	By	Date	Qty	Approval Chief Eng / Prod Mgr	Approval QC Inspector	

Part No: _____ PAR #: _____ Fault Category: _____ NCR: Yes No DQA: _____ Date: _____

Resolution: _____ Disposition: _____ QA: N/C Closed: _____ Date: _____

NCR:		WORK ORDER NON-CONFORMANCE (NCR)						
DATE	STEP	Description of NC Section A	Corrective Action			Verification Section C	Approval Chief Eng	Approval QC Inspector
			Initial Chief Eng	Action Description Chief Eng	Sign & Date			

NOTE: Date & initial all entries

Work Order ID 54369

Page 2

December 8, 2009 11:24:49 AM

Item ID: D3303-041

Accept



Setup Start



Revision ID:

Stop



Item Name: Head Rest

Start Date: 08/12/2009 Start Qty: 40.00



Cust Item ID:

Required Date: 16/12/2009 Req'd Qty: 40.00



Customer:

Reference:

Run Start



Approvals: Process Plan: _____ Date: _____ Tooling: _____ Date: _____

Stop



QC: _____ Date: _____ SPC (Y/N): _____ Date: _____

Sequence ID/
Work Center IDOperation
DescriptionSet Up/
Run HoursDraw
NumberDraw
Rev.Plan
CodeAccept
QtyReject
QtyReject
NumberInsp.
Stamp

130

QC21- Final Inspection - Work Order Release

0.00



QC

Memo

0.00

Quality Control

10/01/25
MF 10-1-25

W/O:		WORK ORDER CHANGES						
DATE	STEP	PROCEDURE CHANGE	By	Date	Qty	Approval Chief Eng / Prod Mgr	Approval QC Inspector	

Part No: _____ PAR #: _____ Fault Category: _____ NCR: Yes No DQA: _____ Date: _____

Resolution: _____ Disposition: _____ QA: N/C Closed: _____ Date: _____

NCR:		WORK ORDER NON-CONFORMANCE (NCR)						
DATE	STEP	Description of NC Section A	Corrective Action Section B			Verification Section C	Approval Chief Eng	Approval QC Inspector
			Initial Chief Eng	Action Description Chief Eng	Sign & Date			

NOTE: Date & initial all entries

Picklist Print

Page 1

December 8, 2009 11:24:52 AM

Work Order ID: 54369



Parent Item: D3303-041



Parent Item Name: Head Rest

Start Date: 08/12/2009

Required Date: 16/12/2009

Comments:

Start Qty: 40.00

Required Qty: 40.00

Component Item ID/ Item Name	Replacement Item ID	Mfg/ Purch	Bin Item	Primary Location	Last Location	Route Seq ID	Unit of Measure	Qty on Hand	Remaining Qty To Pick	Qty Issued	Date Issued	Status
---------------------------------	------------------------	---------------	-------------	---------------------	------------------	-----------------	--------------------	----------------	--------------------------	---------------	----------------	--------

D3303-043

Manufactured

No

100

Each

26.0000

40.0000



Bracket Assembly

Warehouse

Loc Qty

Loc Code

Location

Main Warehouse

ST

26

38968

20

41650

6

D3305-1

Manufactured

No

100

Each

5.0000

40.0000



Cushion

Warehouse

Loc Qty

Loc Code

Location

Main Warehouse

ST

5

40909

5

D3306-041

Manufactured

No

100

Each

7.0000

40.0000



Cover Assembly

Warehouse

Loc Qty

Loc Code

Location

Main Warehouse

ST

7

40910

7

EP 10/01/25

B54439 (20X)

~~18~~

EP 10/01/25

B54440 (20X)

~~5~~

EP 10/01/25

B54441 (20X)

~~5~~

W/O:		WORK ORDER CHANGES						
DATE	STEP	PROCEDURE CHANGE	By	Date	Qty	Approval Chief Eng / Prod Mgr	Approval QC Inspector	

Part No: _____ PAR #: _____ Fault Category: _____ NCR: Yes No DQA: _____ Date: _____

Resolution: _____ Disposition: _____ QA: N/C Closed: _____ Date: _____

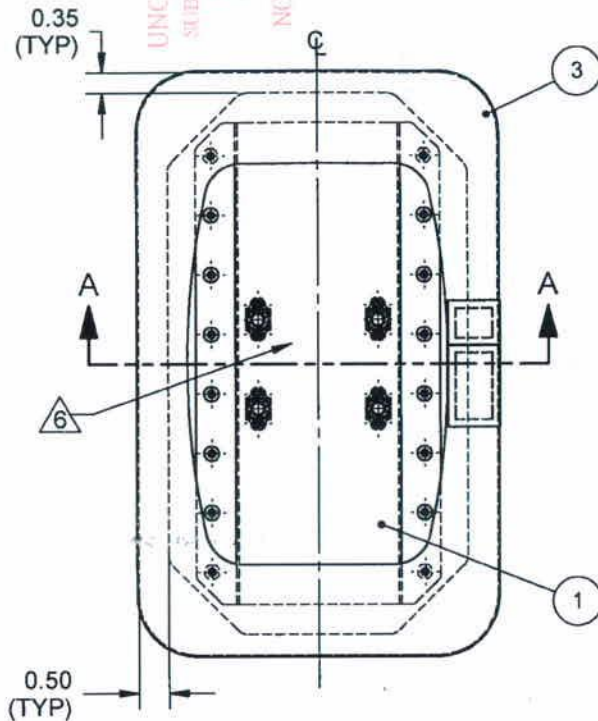
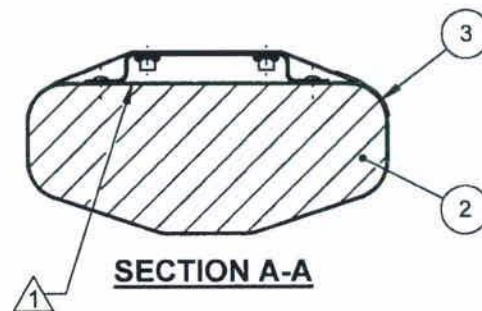
NCR:		WORK ORDER NON-CONFORMANCE (NCR)						
DATE	STEP	Description of NC Section A	Corrective Action Section B			Verification Section C	Approval Chief Eng	Approval QC Inspector
			Initial Chief Eng	Action Description Chief Eng	Sign & Date			

NOTE: Date & initial all entries

DART

STOP COPY
RETURN TO
ENGINEERING
UNCONTROL LTD COPY
SUBJECT TO AGREEMENT
WITHOUT NOTICE
WORK CTR
NO 54309
P/O 912-8

DESIGN <i>[Signature]</i>	DRAWN BY <i>[Signature]</i>	DART AEROSPACE LTD HAWKESBURY, ONTARIO, CANADA	
CHECKED <i>PH</i>	APPROVED <i>[Signature]</i>	DRAWING NO. D3303	REV. B SHEET 1 OF 4
DATE 06.08.17		TITLE HEAD REST	SCALE 1:3
REV A	DATE 04.08.18	DESCRIPTION NEW ISSUE	
B	06.08.17	UPDATED FLAT PATTERN TO FORM PART IN ONE OPERATION USING OFFSET DIE	

**RELEASED***dc-09-19***DEO ATTACHED****D3303-041 HEAD REST**

ITEM	QTY -041	P/N	DESCRIPTION
	X	D3303-041	HEAD REST
1	1	D3303-043	BRACKET ASSEMBLY
2	1	D3305-1	FOAM
3	1	D3306-041	COVER ASSEMBLY

NOTES:

- 1) BOND D3305-1 FOAM TO D3303-043 BRACKET ASSEMBLY USING 3M 1300 ADHESIVE (0.002" TO 0.010" THICK) IN ACCORDANCE WITH MANUFACTURER'S INSTRUCTIONS
- 2) COVER HEAD REST WITH D3306-041 COVER ASSEMBLY AS SHOWN
- 3) PART IS SYMMETRICAL AT CENTERLINE
- 4) TOLERANCES ARE PER DART QSI 018 UNLESS OTHERWISE NOTED
- 5) ALL DIMENSIONS ARE IN INCHES UNLESS OTHERWISE NOTED
- 6) IDENTIFY AS FOLLOWS USING FINE POINT PERMANENT INK MARKER:
"TCCA-PDA, DART AEROSPACE LTD, P/N D3303-041 B/N BXXXXX, FOR PRODUCT ELIGIBILITY SEE PDA04-11"

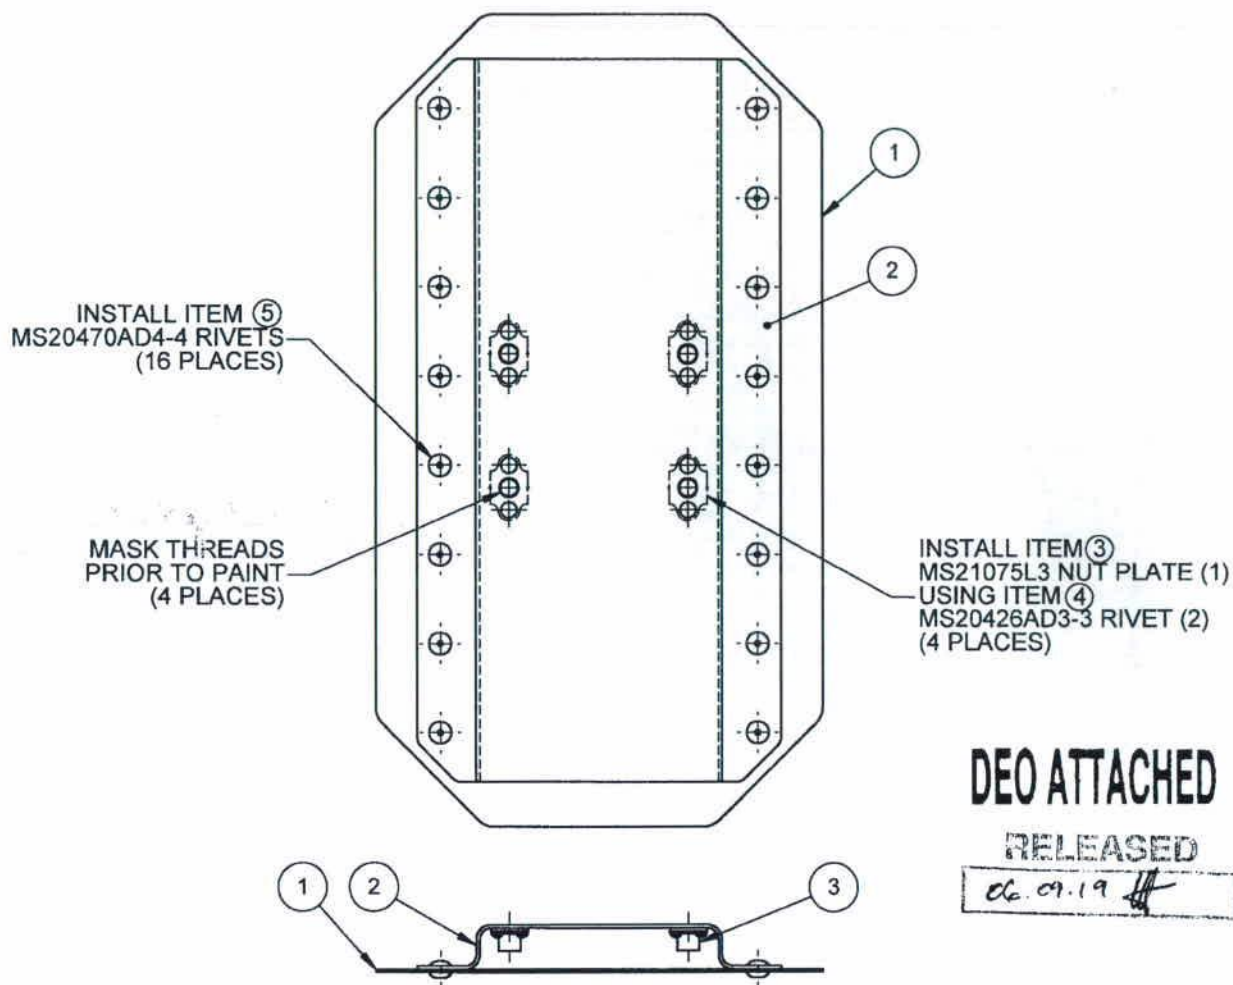
COPYRIGHT © 2004 BY DART AEROSPACE LTD

THIS DOCUMENT IS PRIVATE AND CONFIDENTIAL AND IS SUPPLIED ON THE EXPRESS CONDITION THAT IT IS NOT TO BE USED FOR ANY PURPOSE OR COPIED OR COMMUNICATED TO ANY OTHER PERSON WITHOUT WRITTEN PERMISSION FROM DART AEROSPACE LTD.



w/o 54369

DESIGN <i>[Signature]</i>	DRAWN BY <i>[Signature]</i>	DART AEROSPACE LTD HAWKESBURY, ONTARIO, CANADA	
CHECKED <i>PH</i>	APPROVED <i>[Signature]</i>	DRAWING NO. D3303	REV. B SHEET 2 OF 4
DATE 06.08.17		TITLE HEAD REST	SCALE 1:2



DEO ATTACHED

RELEASED

de. 09.19

D3303-043 BRACKET ASSEMBLY

ITEM	QTY -043	P/N	DESCRIPTION
	X	D3303-043	BRACKET ASSEMBLY
1	1	D3303-1	PLATE
2	1	D3303-3	HEAD REST
3	4	MS21075L3	NUT PLATE
4	8	MS20426AD3-3	RIVET
5	16	MS20470AD4-4	RIVET

NOTES:

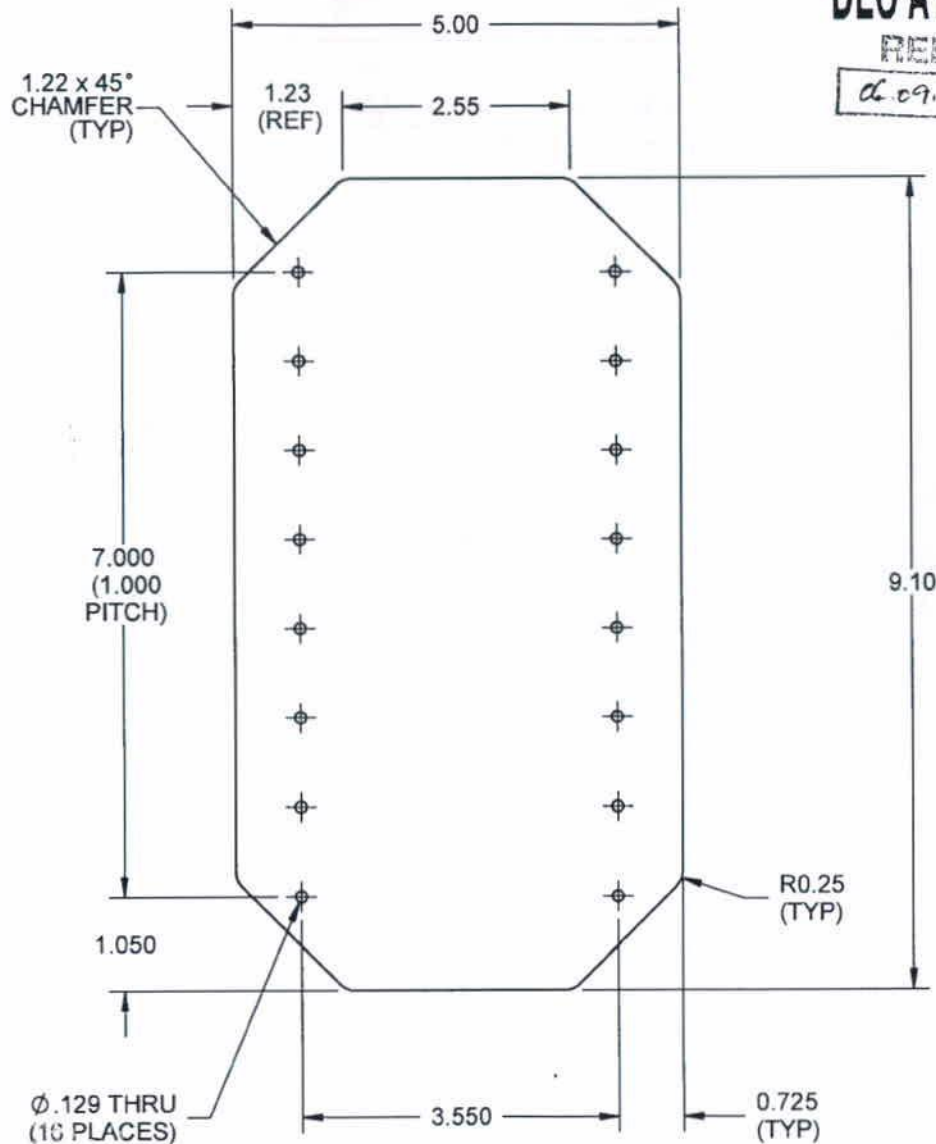
- 1) FINISH: POWDER COAT ASSEMBLY GREY SANDTEX (4.3.5.6) PER DART QSI 005 4.3
- 2) TOLERANCES ARE PER DART QSI 018 UNLESS OTHERWISE NOTED
- 3) ALL DIMENSIONS ARE IN INCHES UNLESS OTHERWISE NOTED

COPYRIGHT © 2004 BY DART AEROSPACE LTD

THIS DOCUMENT IS PRIVATE AND CONFIDENTIAL AND IS SUPPLIED ON THE EXPRESS CONDITION THAT IT IS NOT TO BE USED FOR ANY PURPOSE OR COPIED OR COMMUNICATED TO ANY OTHER PERSON WITHOUT WRITTEN PERMISSION FROM DART AEROSPACE LTD.

DART

DESIGN <i>[Signature]</i>	DRAWN BY <i>[Signature]</i>	DART AEROSPACE LTD HAWKESBURY, ONTARIO, CANADA	
CHECKED <i>PH</i>	APPROVED <i>[Signature]</i>	DRAWING NO. D3303	REV. B SHEET 3 OF 4
DATE 06.08.17		TITLE HEAD REST	SCALE 1:2

**D3303-1 PLATE****NOTES:**

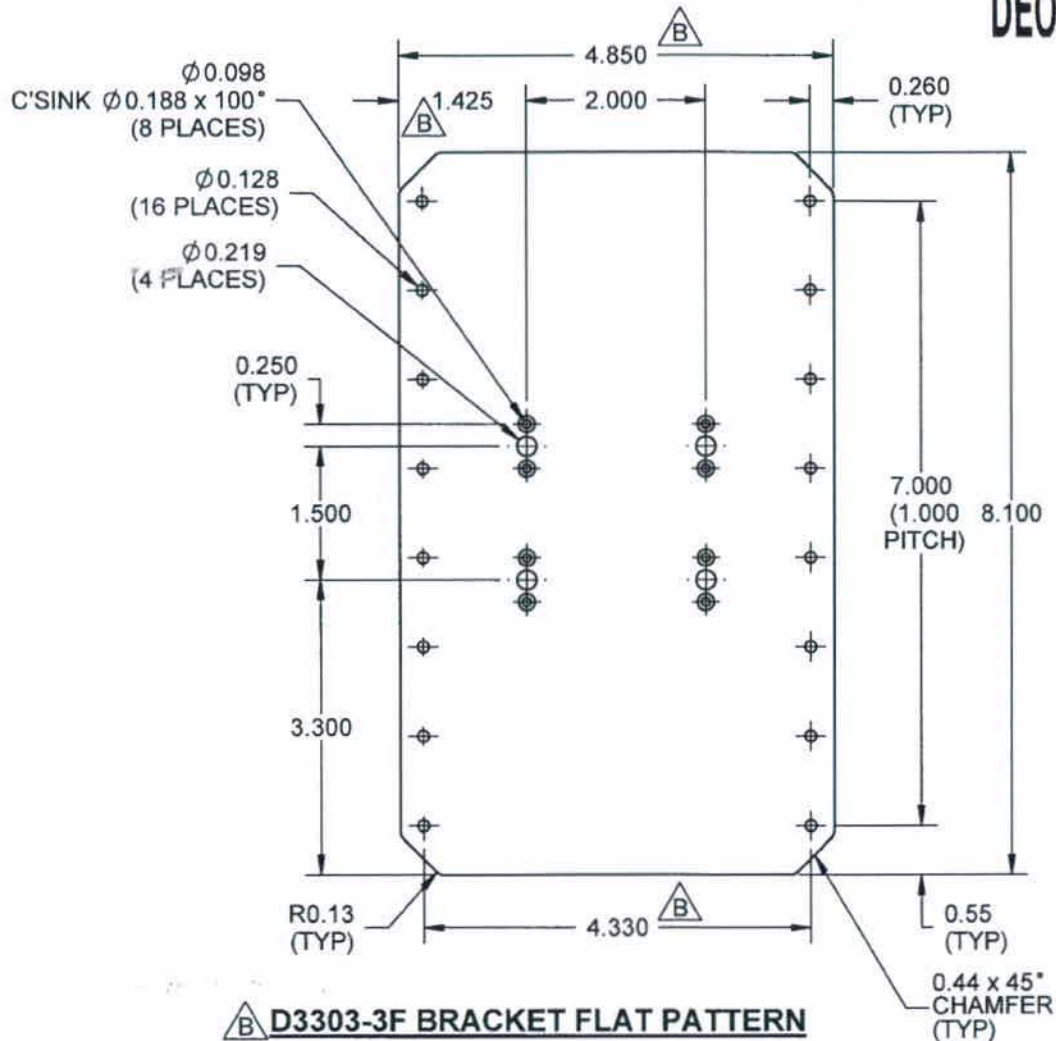
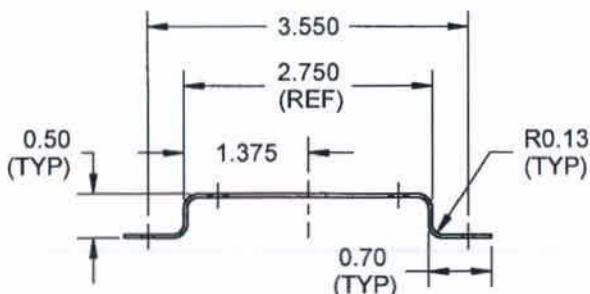
- 1) MATERIAL: 2024-T3 (QQ-A-250/4) 0.032 THICK SHEET
(REF. DART SPEC. M2024T3S.032)
- 2) FINISH: CHEMICAL CONVERSION COAT AS PER DART QSI 005.4.1
- 3) TOLERANCES ARE PER DART QSI 018 UNLESS OTHERWISE NOTED
- 4) ALL DIMENSIONS ARE IN INCHES UNLESS OTHERWISE NOTED
- 5) BREAK ALL SHARP EDGES 0.005 TO 0.015

COPYRIGHT © 2004 BY DART AEROSPACE LTD

THIS DOCUMENT IS PRIVATE AND CONFIDENTIAL AND IS SUPPLIED ON THE EXPRESS CONDITION THAT IT IS NOT TO BE USED FOR ANY PURPOSE OR COPIED OR COMMUNICATED TO ANY OTHER PERSON WITHOUT WRITTEN PERMISSION FROM DART AEROSPACE LTD.

DART

DESIGN <i>[Signature]</i>	DRAWN BY <i>[Signature]</i>	DART AEROSPACE LTD HAWKESBURY, ONTARIO, CANADA	
CHECKED <i>PH</i>	APPROVED <i>[Signature]</i>	DRAWING NO. D3303	REV. B SHEET 4 OF 4
DATE 06.08.17		TITLE HEAD REST	SCALE 1:2

DEO ATTACHED**D3303-3F BRACKET FLAT PATTERN****D3303-3 BRACKET BEND DETAIL****NOTES:**

- 1) MATERIAL: 2024-T3 (QQ-A-250/4) 0.040 THICK SHEET (REF. DART SPEC. M2024T3S.040)
- 2) FINISH: CHEMICAL CONVERSION COAT AS PER DART QSI 005.4.1
- 3) TOLERANCES ARE PER DART QSI 018 UNLESS OTHERWISE NOTED
- 4) ALL DIMENSIONS ARE IN INCHES UNLESS OTHERWISE NOTED
- 5) BREAK ALL SHARP EDGES 0.005 TO 0.015

COPYRIGHT © 2004 BY DART AEROSPACE LTD

THIS DOCUMENT IS PRIVATE AND CONFIDENTIAL AND IS SUPPLIED ON THE EXPRESS CONDITION THAT IT IS NOT TO BE USED FOR ANY PURPOSE OR COPIED OR COMMUNICATED TO ANY OTHER PERSON WITHOUT WRITTEN PERMISSION FROM DART AEROSPACE LTD.

DRAWING NO. D3303	TITLE HEAD REST	REV. B	DART AEROSPACE LTD ENGINEERING ORDER		D.E.O. NO. D3303-B-1	SHEET NO. SHEET 1 OF 1	SCALE NTS
DRAWN AJS	CHECKED <i>h</i>	MFG. APPR. <i>h</i>	APPROVED <i>h</i>	DE APPR. <i>h</i>			
DATE 08.10.15	DATE <i>08.10.15</i>	DATE <i>08/10/16</i>	DATE <i>08/10/16</i>	DATE <i>08/10/16</i>			

SHEET 1 ADD 1300L ADHESIVE BY 3M TO NOTE 1 AS FOLLOWS:

IS:

NOTES:

- 1) BOND D3305-1 FOAM TO D3303-043 BRACKET ASSEMBLY USING 3M 1300 OR 1300L ADHESIVE (0.002" TO 0.010" THICK) IN ACCORDANCE WITH MANUFACTURER'S INSTRUCTIONS

WAS:

NOTES:

- 1) BOND D3305-1 FOAM TO D3303-043 BRACKET ASSEMBLY USING 3M 1300 ADHESIVE (0.002" TO 0.010" THICK) IN ACCORDANCE WITH MANUFACTURER'S INSTRUCTIONS

SEE NCR 08-069 FOR FURTHER DETAILS

RELEASED
08/11/16

1416 543619